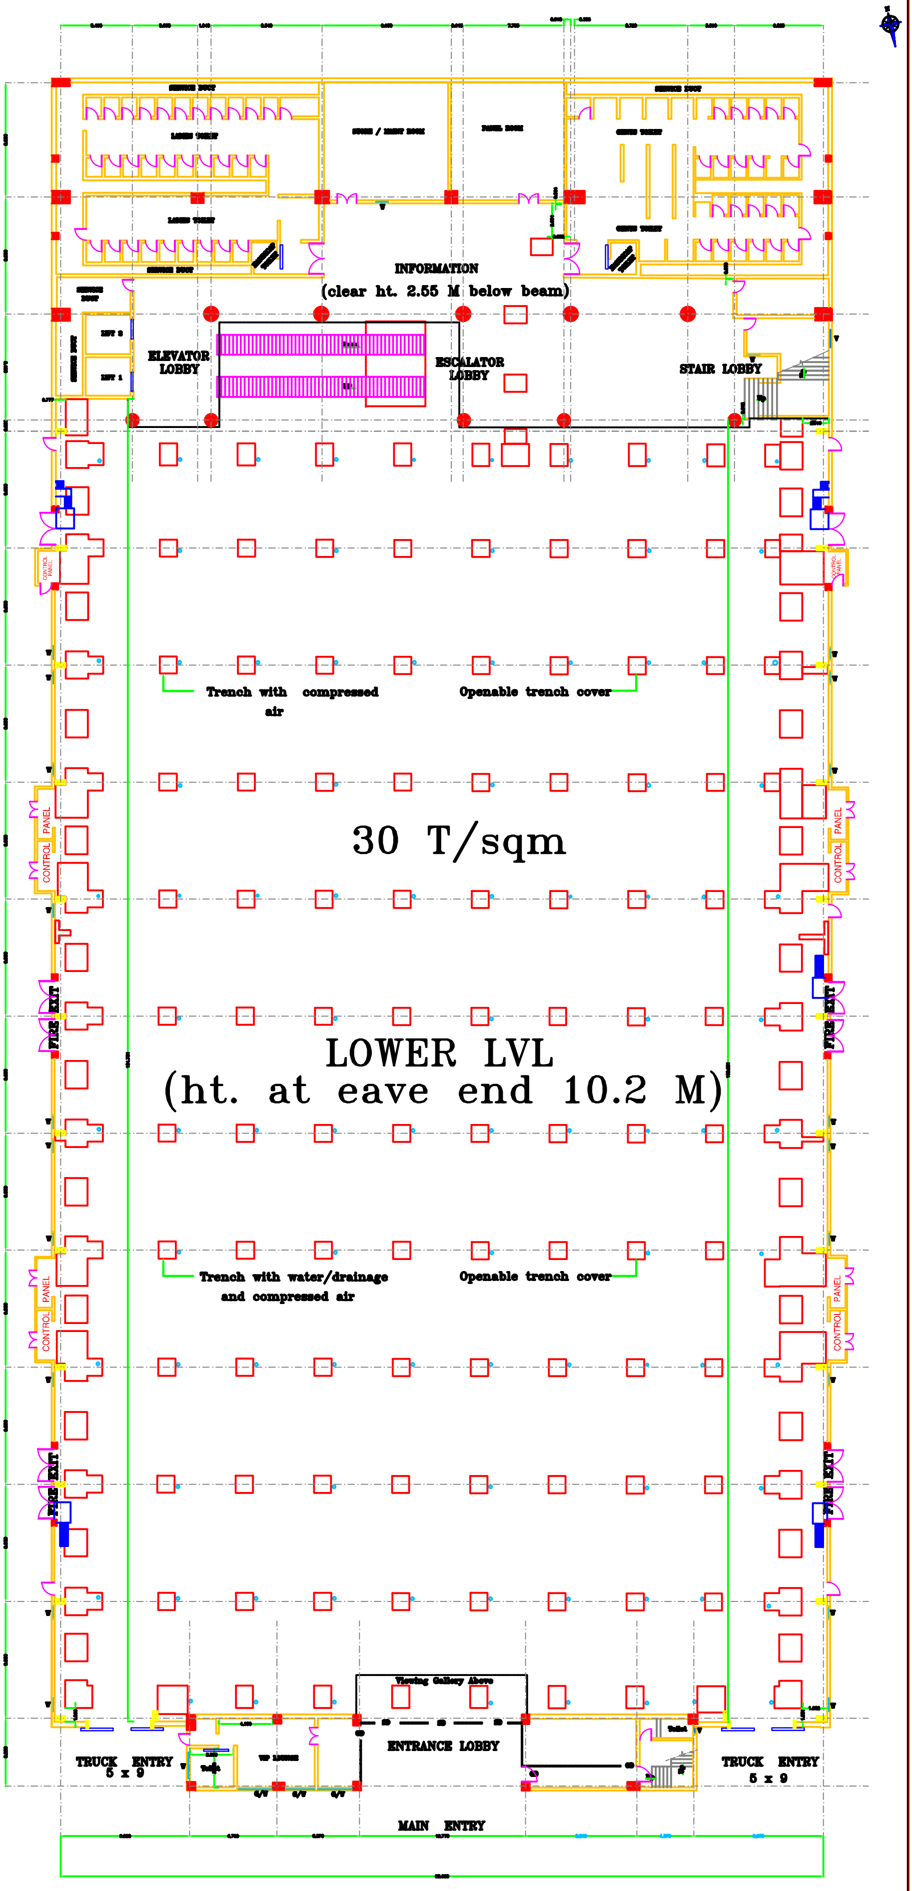

EXHIBITION HALL 1 -LOWER LEVEL

AS-BUILT PLAN OF EXHIBITION HALL -1 LOWER LEVEL AT BANGALORE INTERNATIONAL EXHIBITION CENTRE PREMISES ON TUMKUR ROAD, 10TH MILE, BANGALORE

M/s.B.I.E.C
Bangalore

SCALE	SEASON	SHEET NO	REV: 0
1:100	SEP-2013	1 OF 1	

SURVEYED & DRAWN BY:

E-CON SURVEYS

NO.48, 7th Main, Opp. Javaregowda Building, Chowdappa Coconut Garden, Hosakerehalli, Bangalore-560085